DO NOT SCALE DRAWING

REVISIONS					
REV.		E.C.N.	BY	APPD.	DATE
1	RELEASED TO MANUFACT		CRM		10/08
2	RELEASED AS BUILT		CRM		10/08

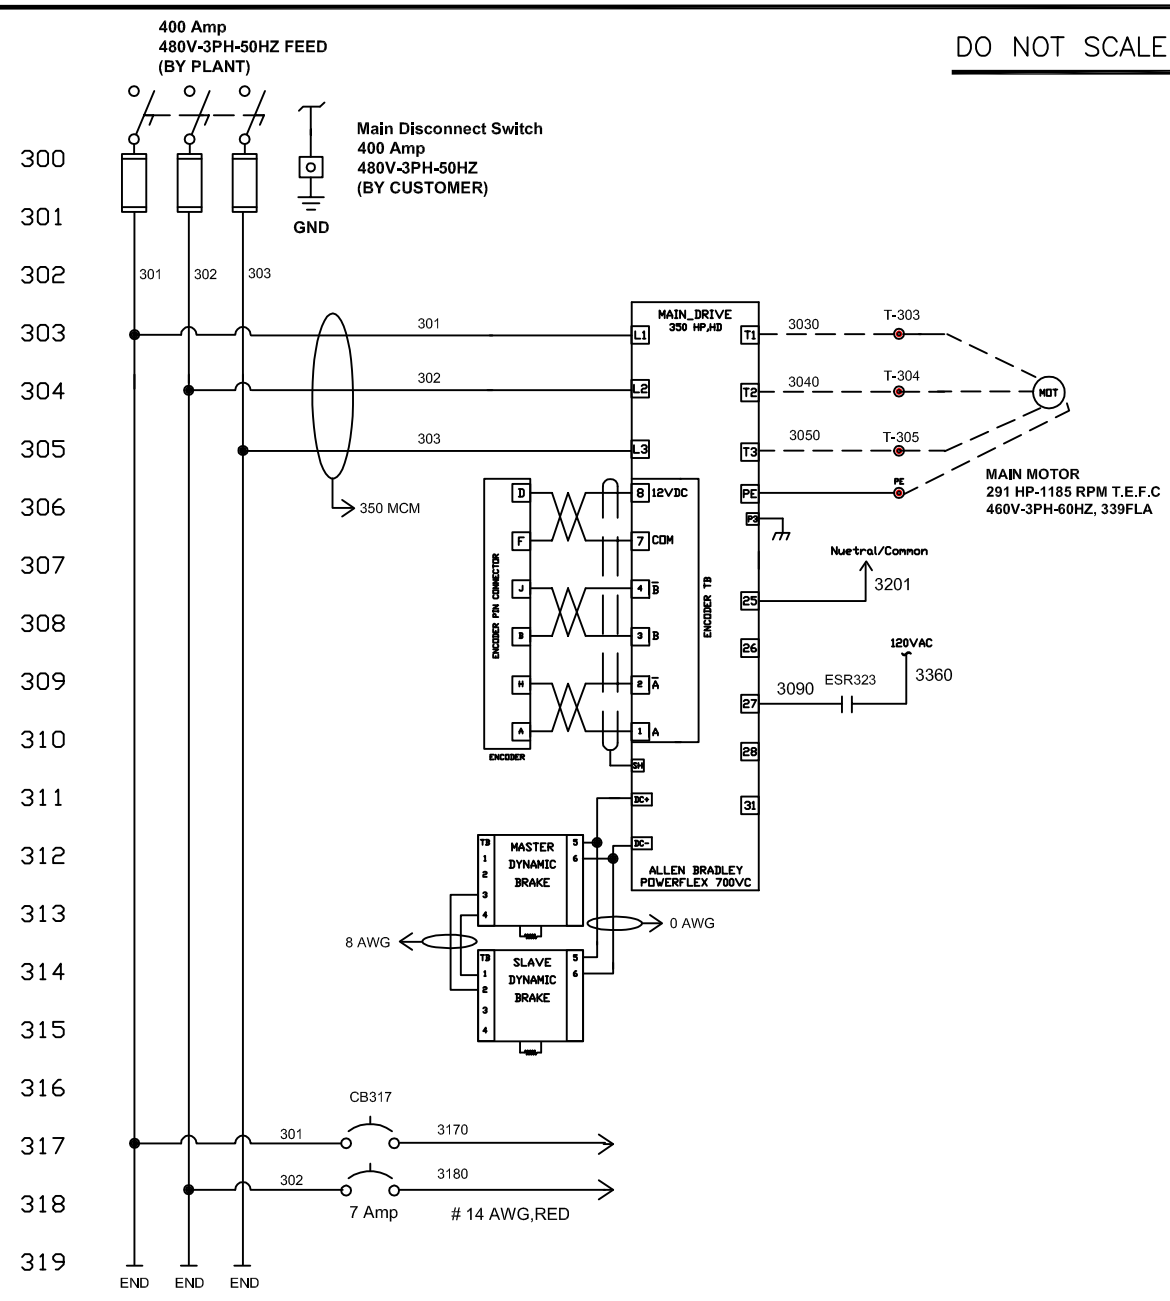

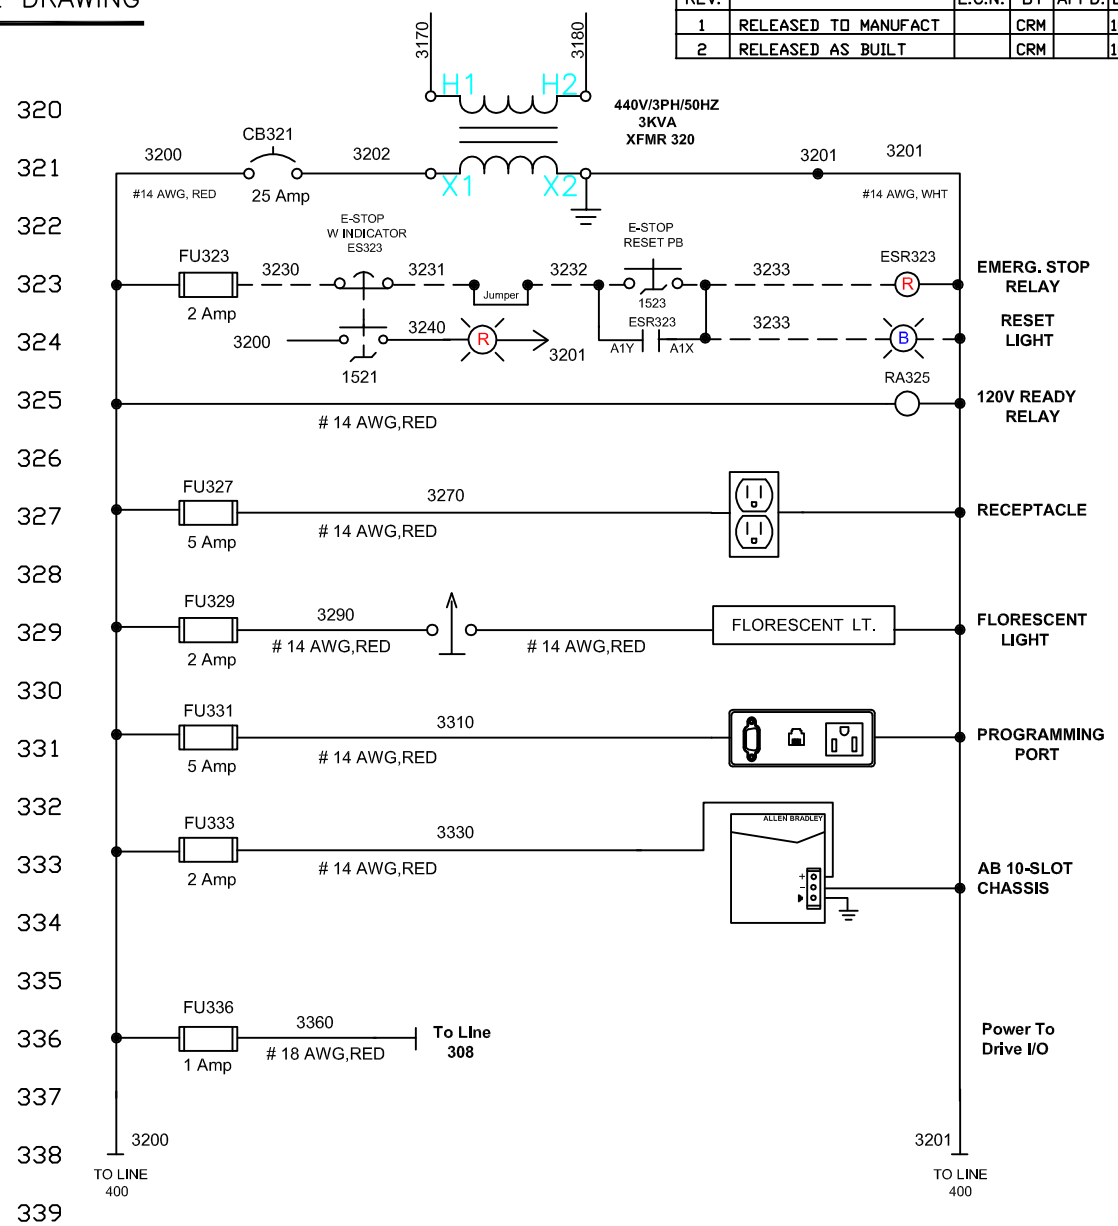

General Note: Solid Lines denotes Internal Main Panel wiring; dashed lines are field wiring.

CONFIDENTIALITY NOTICE: Golden Groove Sugar. This sheet contains confidential, proprietary information of St.Thomas Sugar Mill. By accepting this sheet and/or information agrees to make no disclosure, use or duplication thereof, except as authorized in writing by St. Sugar Mill, and to return or destroy this sheet and all copies, upon request. ©2008 through date of last revision listed on this sheet. Golden Groove Sugar

THIRD ANGLE PROJECTION	MATERIAL	SIGNATURES	DATE	Automated Design & Control,LLC. Lehigh Acres, Florida 33971
NEXT ASSY | USED ON	ALL DIMENSIONS ARE GIVEN IN INCHES INTERPRET DIM'S AND TOL. PER ASME Y14.5-1994	DRAWN C. R. M.	09/30/08	Centrifugal #4 Power Distribution 440-120 VAC
APPLICATION	TOLERANCES UNLESS OTHERWISE SPECIFIED .X ± 0.1 [± 2.54] .XX ± 0.01 [± 0.25] .XXX ± 0.005 [± 0.79] ANGLES ± 1/2°	CHECK		
		ENGR. C. R. M.	09/30/08	
		APPROVED		

SIZE	SCALE	DWG. NO.	REV
	N/A	GGSC030408-03	A
PROJ. NO.		SHEET 3 OF 22	